SEA DIAMOND XVI

GENERAL ARRANGEMENT

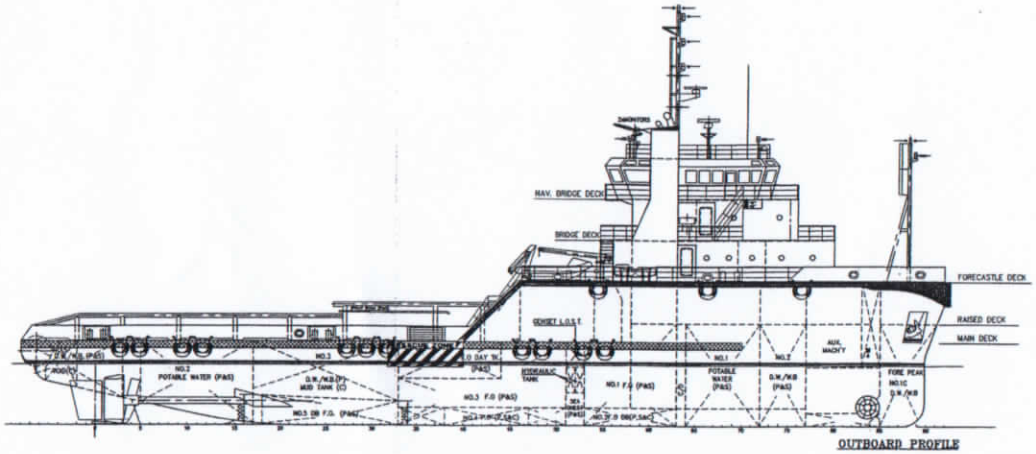

OUTBOARD PROFILE

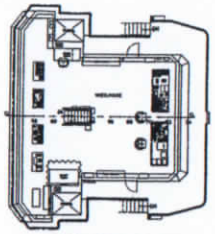

NAV. BRIDGE DECK

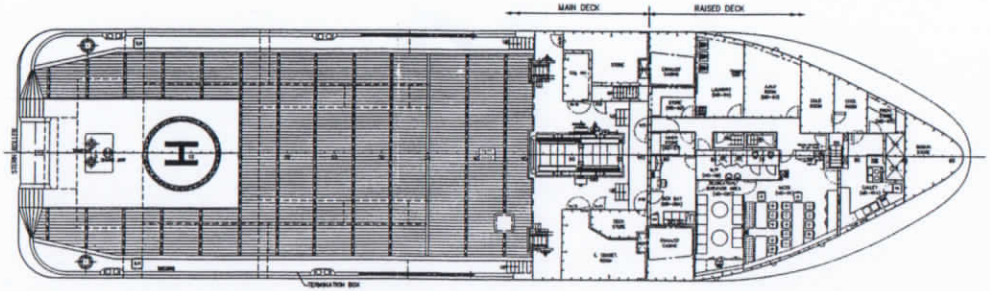

MAIN DECK

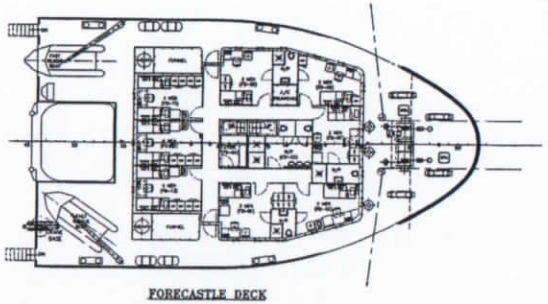

FORECASTLE DECK

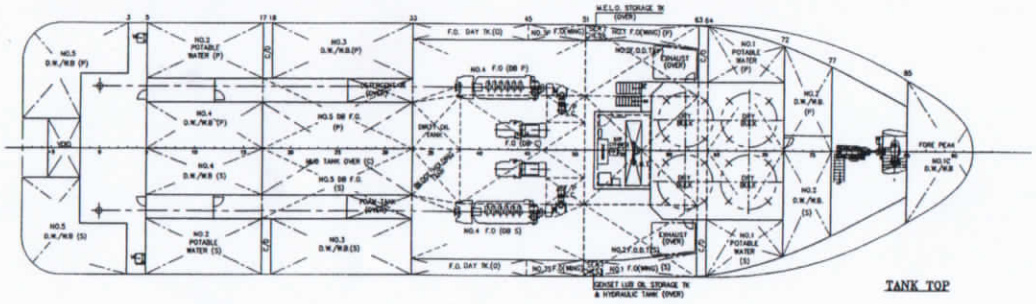

TANK TOP

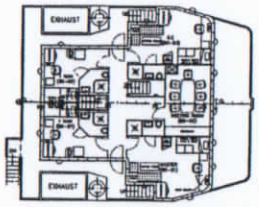

BRIDGE DECK

PRINCIPAL PARTICULARS

LENGTH O.A	60.00m	
LENGTH W.L	58.70m	
BEAM MLD.	16.00m	
DEPTH MLD.	5.50m	
DRAFT DESIGNED	4.20m	
FRAME SPACING	600mm	
COMPLEMENT	26 MEN	
POTABLE WATER	280m³	(approx.)
F.O	508m³	(approx.)
D.W./S.W.B.	778m³	(approx.)
LIQUID MUD	206m³	(approx.)
DRY BULK	150m³	(approx.)
DECK SPACE	360m²	(approx.)

ABS ✠ A1 Ⓔ ✠ AMS FIFI 1
"TOWING AND ANCHOR HANDLING SERVICES"

Keppel Singmarine

Keppel Singmarine Dockyard Pte Ltd
Main Yard
55 Gul Road
Singapore 629353
Tel: (65) 8613007
Fax: (65) 8623645
(65) 8623647
Telex: RS 24050 SLIPCO

Date:	25-07-2001	Scale:	1:150
Designed By:	KSD	Hull No.:	H257
Drawn:	DEVA	Eng. Proj. No.:	
Checked:		Basic Design Appr'd:	

Job: 60m ANCHOR HANDLING/SUPPLY VESSEL

Title: GENERAL ARRANGEMENT

Drawing No.: C3317G1(AS BUILT) Sheet 1 Of 1 Sheets Rev. 0